139
139

PLATE NO. 3

~~CONFIDENTIAL~~

SELECTED RECORD PLAN

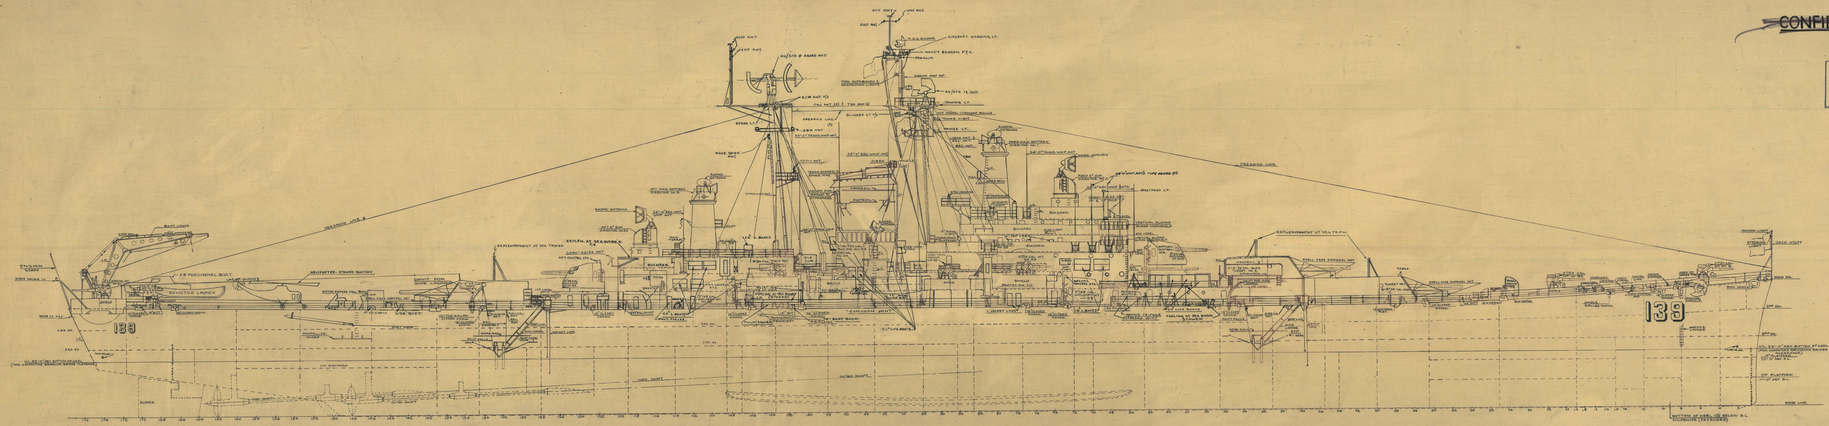

OUTBOARD PROFILE

U.S.S. SALEM CA 139
BUREAU OF SHIPS NO. CA 139-S0103-531700
SCALE ½" = 1 FOOT

PLATE NO. 4

~~CONFIDENTIAL~~

SELECTED RECORD PLAN

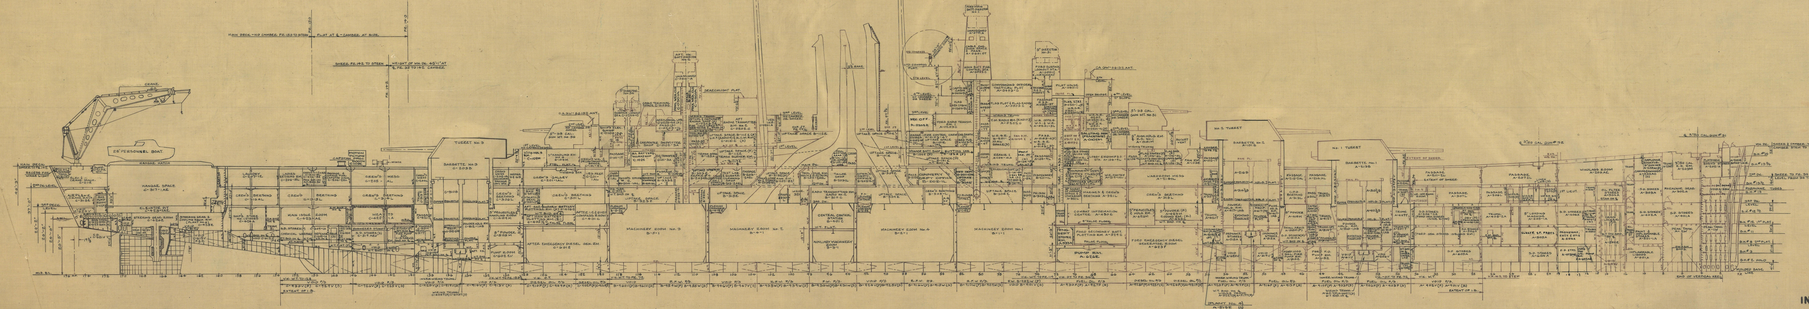

INBOARD PROFILE

U.S.S. SALEM CA 139
BUREAU OF SHIPS NO. CA 139-S0103-531700
SCALE ½" = 1 FOOT

1572	CA 139	BETHLEHEM - QUINCY
HULL NO.	SHIP NO.	CONTRACTOR

BETHLEHEM STEEL CO.
SHIPBUILDING DIVISION
QUINCY YARD HULL DEPARTMENT QUINCY, MASS.

SCALE 1/8" = 1'-0" DATE 6 JUNE 41
DRAWN J.R.M. FINISHED 10 JUNE 41
TRACED APPROVED C.A.C.
CHECKED J.A.T. APPROVED A.B.

PLAN NO. 1572-11-20 SH. 2

SELECTED RECORD PLAN

APPROVED DATE NOV 13 1944

R.S. Hitchcock
SUPERVISOR OF SHIPBUILDING, U.S.N., QUINCY, MASS.
BY DIRECTION

BOOKLET OF GENERAL PLANS
INBOARD & OUTBOARD PROFILES

BUREAU OF SHIPS PLAN NUMBER			
INDEX	GROUP	FILE NO.	ALTERATION NO.
CA 139	S0103	531700	

22300 84/2

SUPERVISOR OF SHIPBUILDING
BETHLEHEM STEEL COMPANY
QUINCY, MASS.

APR 2 1945	APR 27 1945
AUG 30 1945	NOV 13 1945
NOV 9 1945	APR 5 1949

CA 139

CA 139

CA 139

CA 139

Declassified Under Authority of E.O. 13526, DON Privacy Sensitive: May Contain PII, Date: 11/14/2023

PLATE NO.5

~~CONFIDENTIAL~~

SELECTED RECORD PLAN

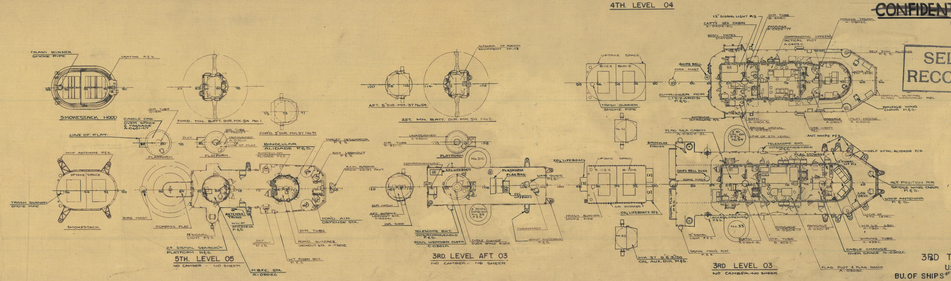

3RD TO 5TH LEVELS
USS SALEM
BU. OF SHIPS NO. CA139-S0103-531700
SCALE ½"=1FOOT

PLATE NO.6

~~CONFIDENTIAL~~

SELECTED RECORD PLAN

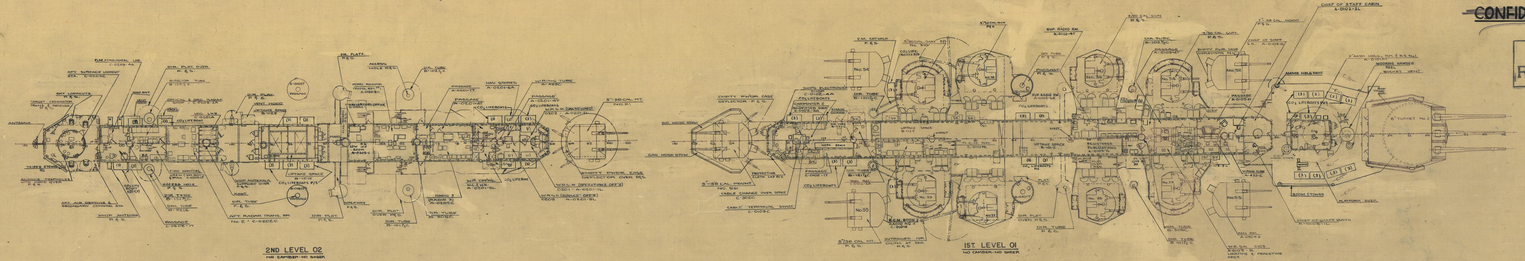

1ST & 2ND LEVELS
USS SALEM
BU. OF SHIPS NO. CA139-S0103-531700
SCALE ½"=1FOOT

PLATE NO.7

~~CONFIDENTIAL~~

SELECTED RECORD PLAN

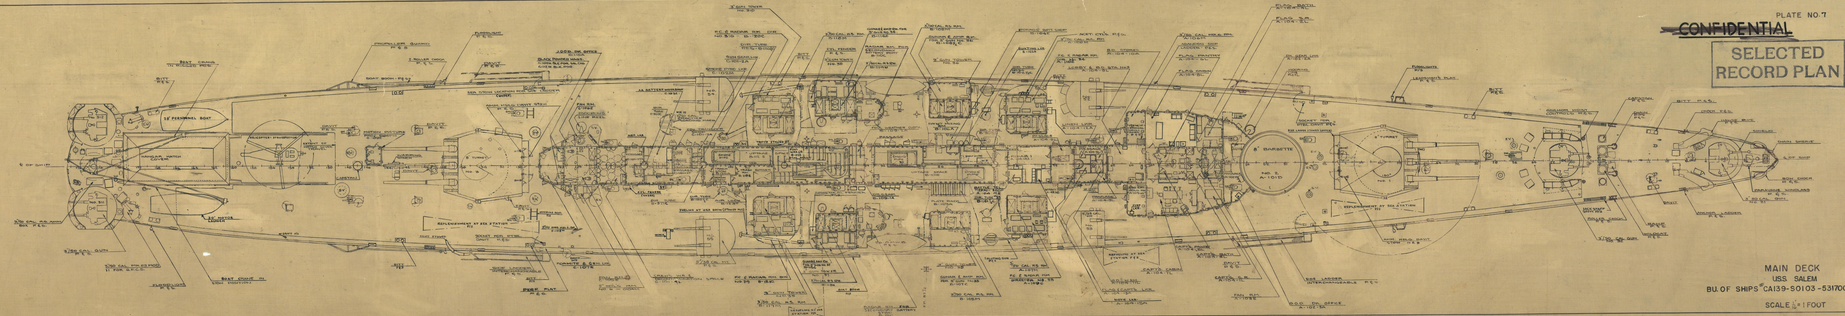

MAIN DECK
USS SALEM
BU. OF SHIPS NO. CA139-S0103-531700
SCALE ½"=1FOOT

AREA = 27 + 791 + 4258 SQ. FT.

1572	CA 139	BETHLEHEM-QUINCY
HULL No.	SHIP No.	CONTRACT#

BETHLEHEM STEEL CO.
QUINCY YARD · SHIPBUILDING DIVISION · QUINCY, MASS.
HULL DEPARTMENT

SCALE ½"=1FT. DATE 25TH MAY 43
DRAWN IN CHARGE A. Nast
TRACED B.I.M. 5-31-43 CH. DFTSMAN Carey
CHECKED 5-31-43 APPROVED [illegible]

PLAN NO. 1572-11-20 SH. 3

SELECTED RECORD PLAN

APPROVED DATE JUNE 9 1943
B. B. Hitchcock
SUPERINTENDENT SHIPBUILDING DIVISION
BY DIRECTION

BOOKLET OF GENERAL PLANS

MAIN DECK
& 1ST TO 5TH LEVELS

BUREAU OF SHIPS PLAN NUMBER			ALTERATION No.
CA139	S0103	531700	

SCALE OF ORIGINAL
SCALE OF PRINTS DATE 25-2-5-6 DRAWING

2.2300 SH 15 5

OFFICE OF SUPERVISOR OF SHIPBUILDING FOR U.S. NAVY BETHLEHEM STEEL CO. QUINCY, MASS.
JUN 25 1945 JUN 2 1945
JUN 5 1945 JUN 8 1945
MAY 5 1945 APR 24 1945

CA 139

CA 139

CA 139

MIN MK 1 to 2 in TEMPO

TSD 24-A-23 SHT 5 OF 15-11-20